



Hems

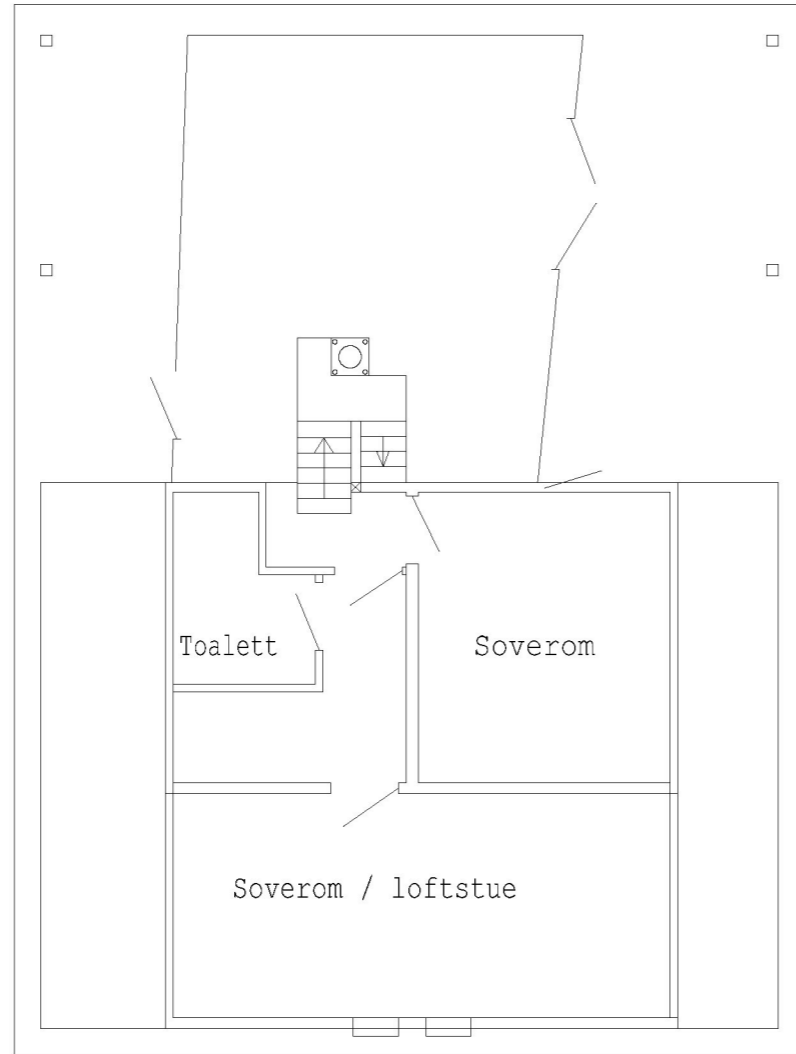

Snitt

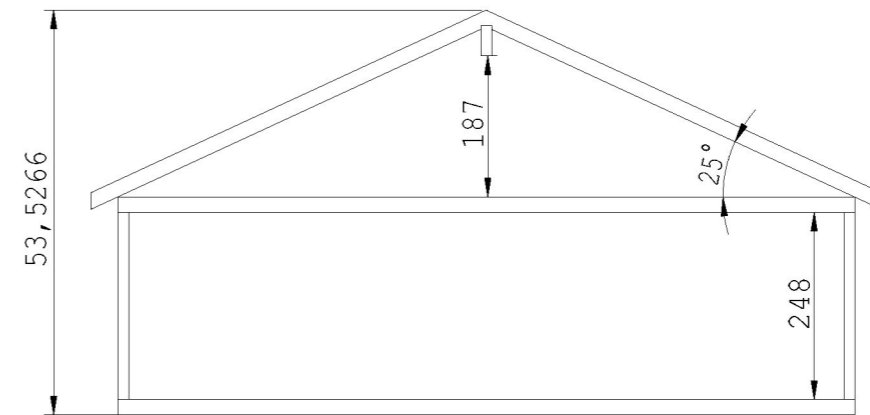

|                  |                        |
|------------------|------------------------|
| Date: 03.01.2002 | Title:                 |
| Drawn by: GNE    | As Built Drawing       |
| Scale: 1 : 100   | Gnr. 122 Br.nr. 77/141 |
|                  | Tilbygg hytte          |