




Vest

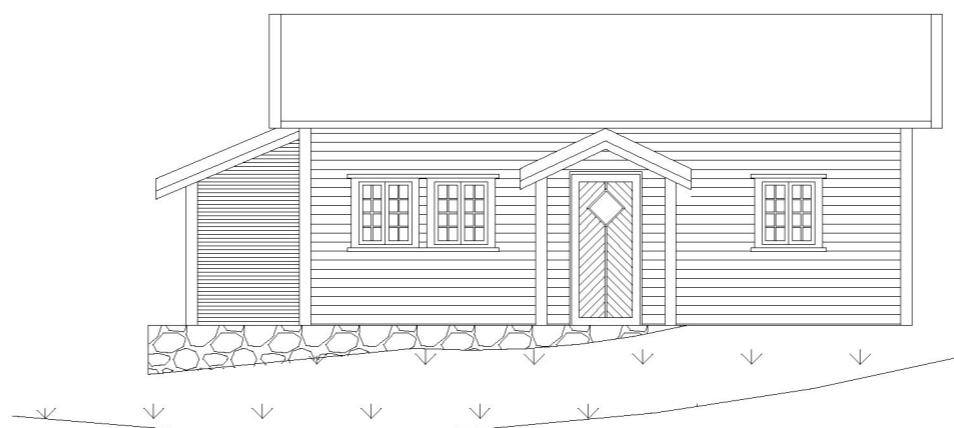

Sør

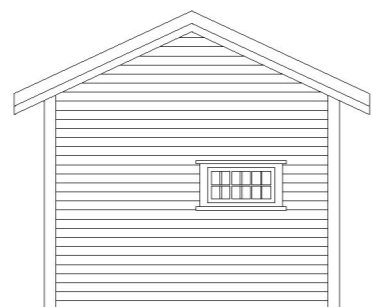

Øst

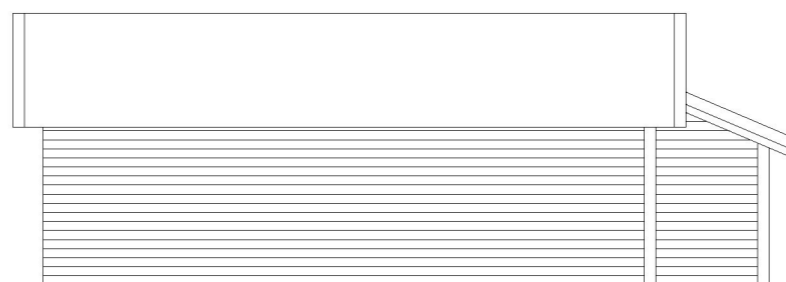

Nord

Date: 01.10.2021	Title:
Drawn by: GNE	As Built Drawing
Scale: 1 : 100	Gnr. 122 Br.nr. 77
	"Jærhuset"